DEPARTMENT OF MENTAL HYGIENE AND HOSPITALS

DR. HIRAM W. DAVIS — COMMISSIONER

WESTERN STATE HOSPITAL

STAUNTON — VIRGINIA

DR. HOBART G. HANSEN — SUPERINTENDENT

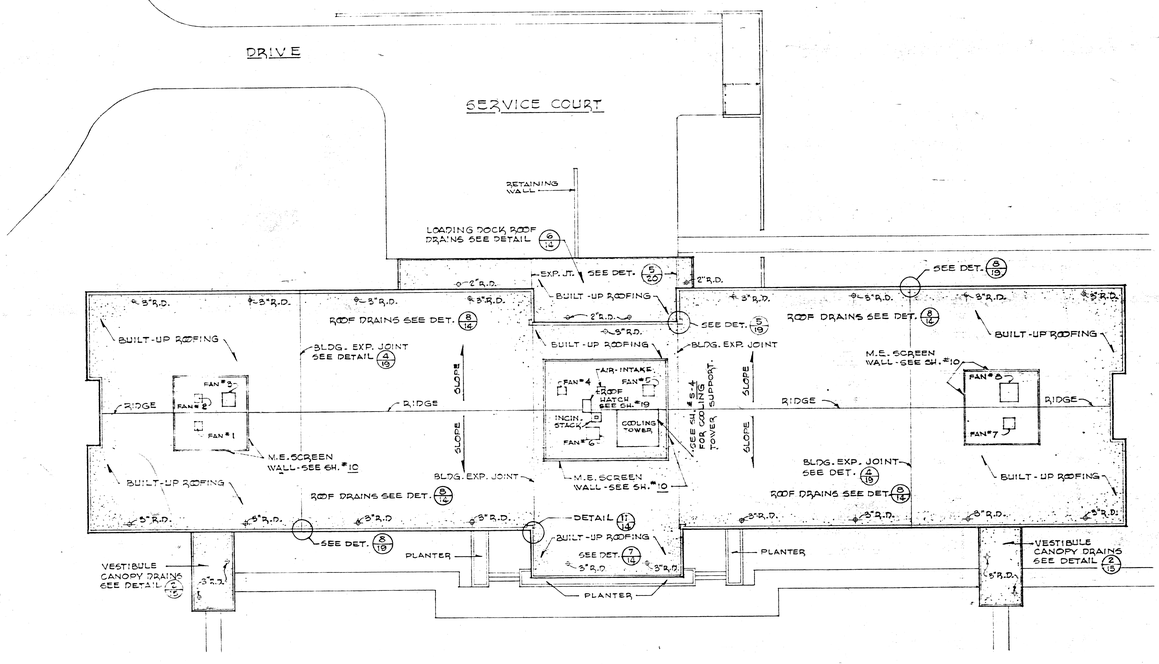

ROOF PLAN
SCALE: 1" = 20'

NOTES:
LIGHTWEIGHT INSULATING ROOF FILL VARIES FROM 6" THICK AT RIDGE TO 2" THICK AT DRAINS.
PROVIDE 1" TRANSVERSE EXPANSION JOINTS EVERY 50'-0" AS WELL AS 1" PERIMETER EXPANSION JOINTS FOR LIGHTWEIGHT INSULATING ROOF FILL.

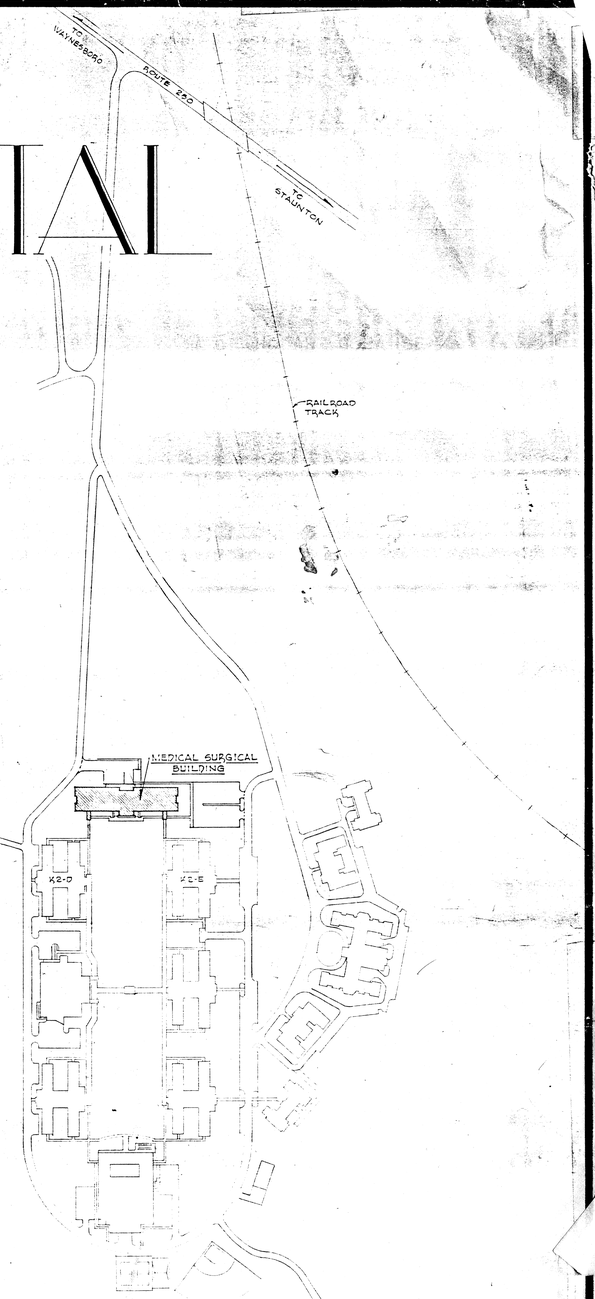

LOCATION PLAN
SCALE 1" = 200'

MEDICAL - SURGICAL BUILDING

MARCELLUS WRIGHT & PARTNERS
ARCHITECTS - ENGINEERS — RICHMOND, VIRGINIA

WILEY & WILSON - MECHANICAL ENGINEERS
LYNCHBURG, VIRGINIA

HENRY W. ROBERTS - STRUCTURAL ENGINEER
RICHMOND, VIRGINIA

PROJECT NO. 706-49

DATE: JANUARY, 1967

"AS BUILT" OCTOBER, 1968

122

SHEET NO 1 OF 20

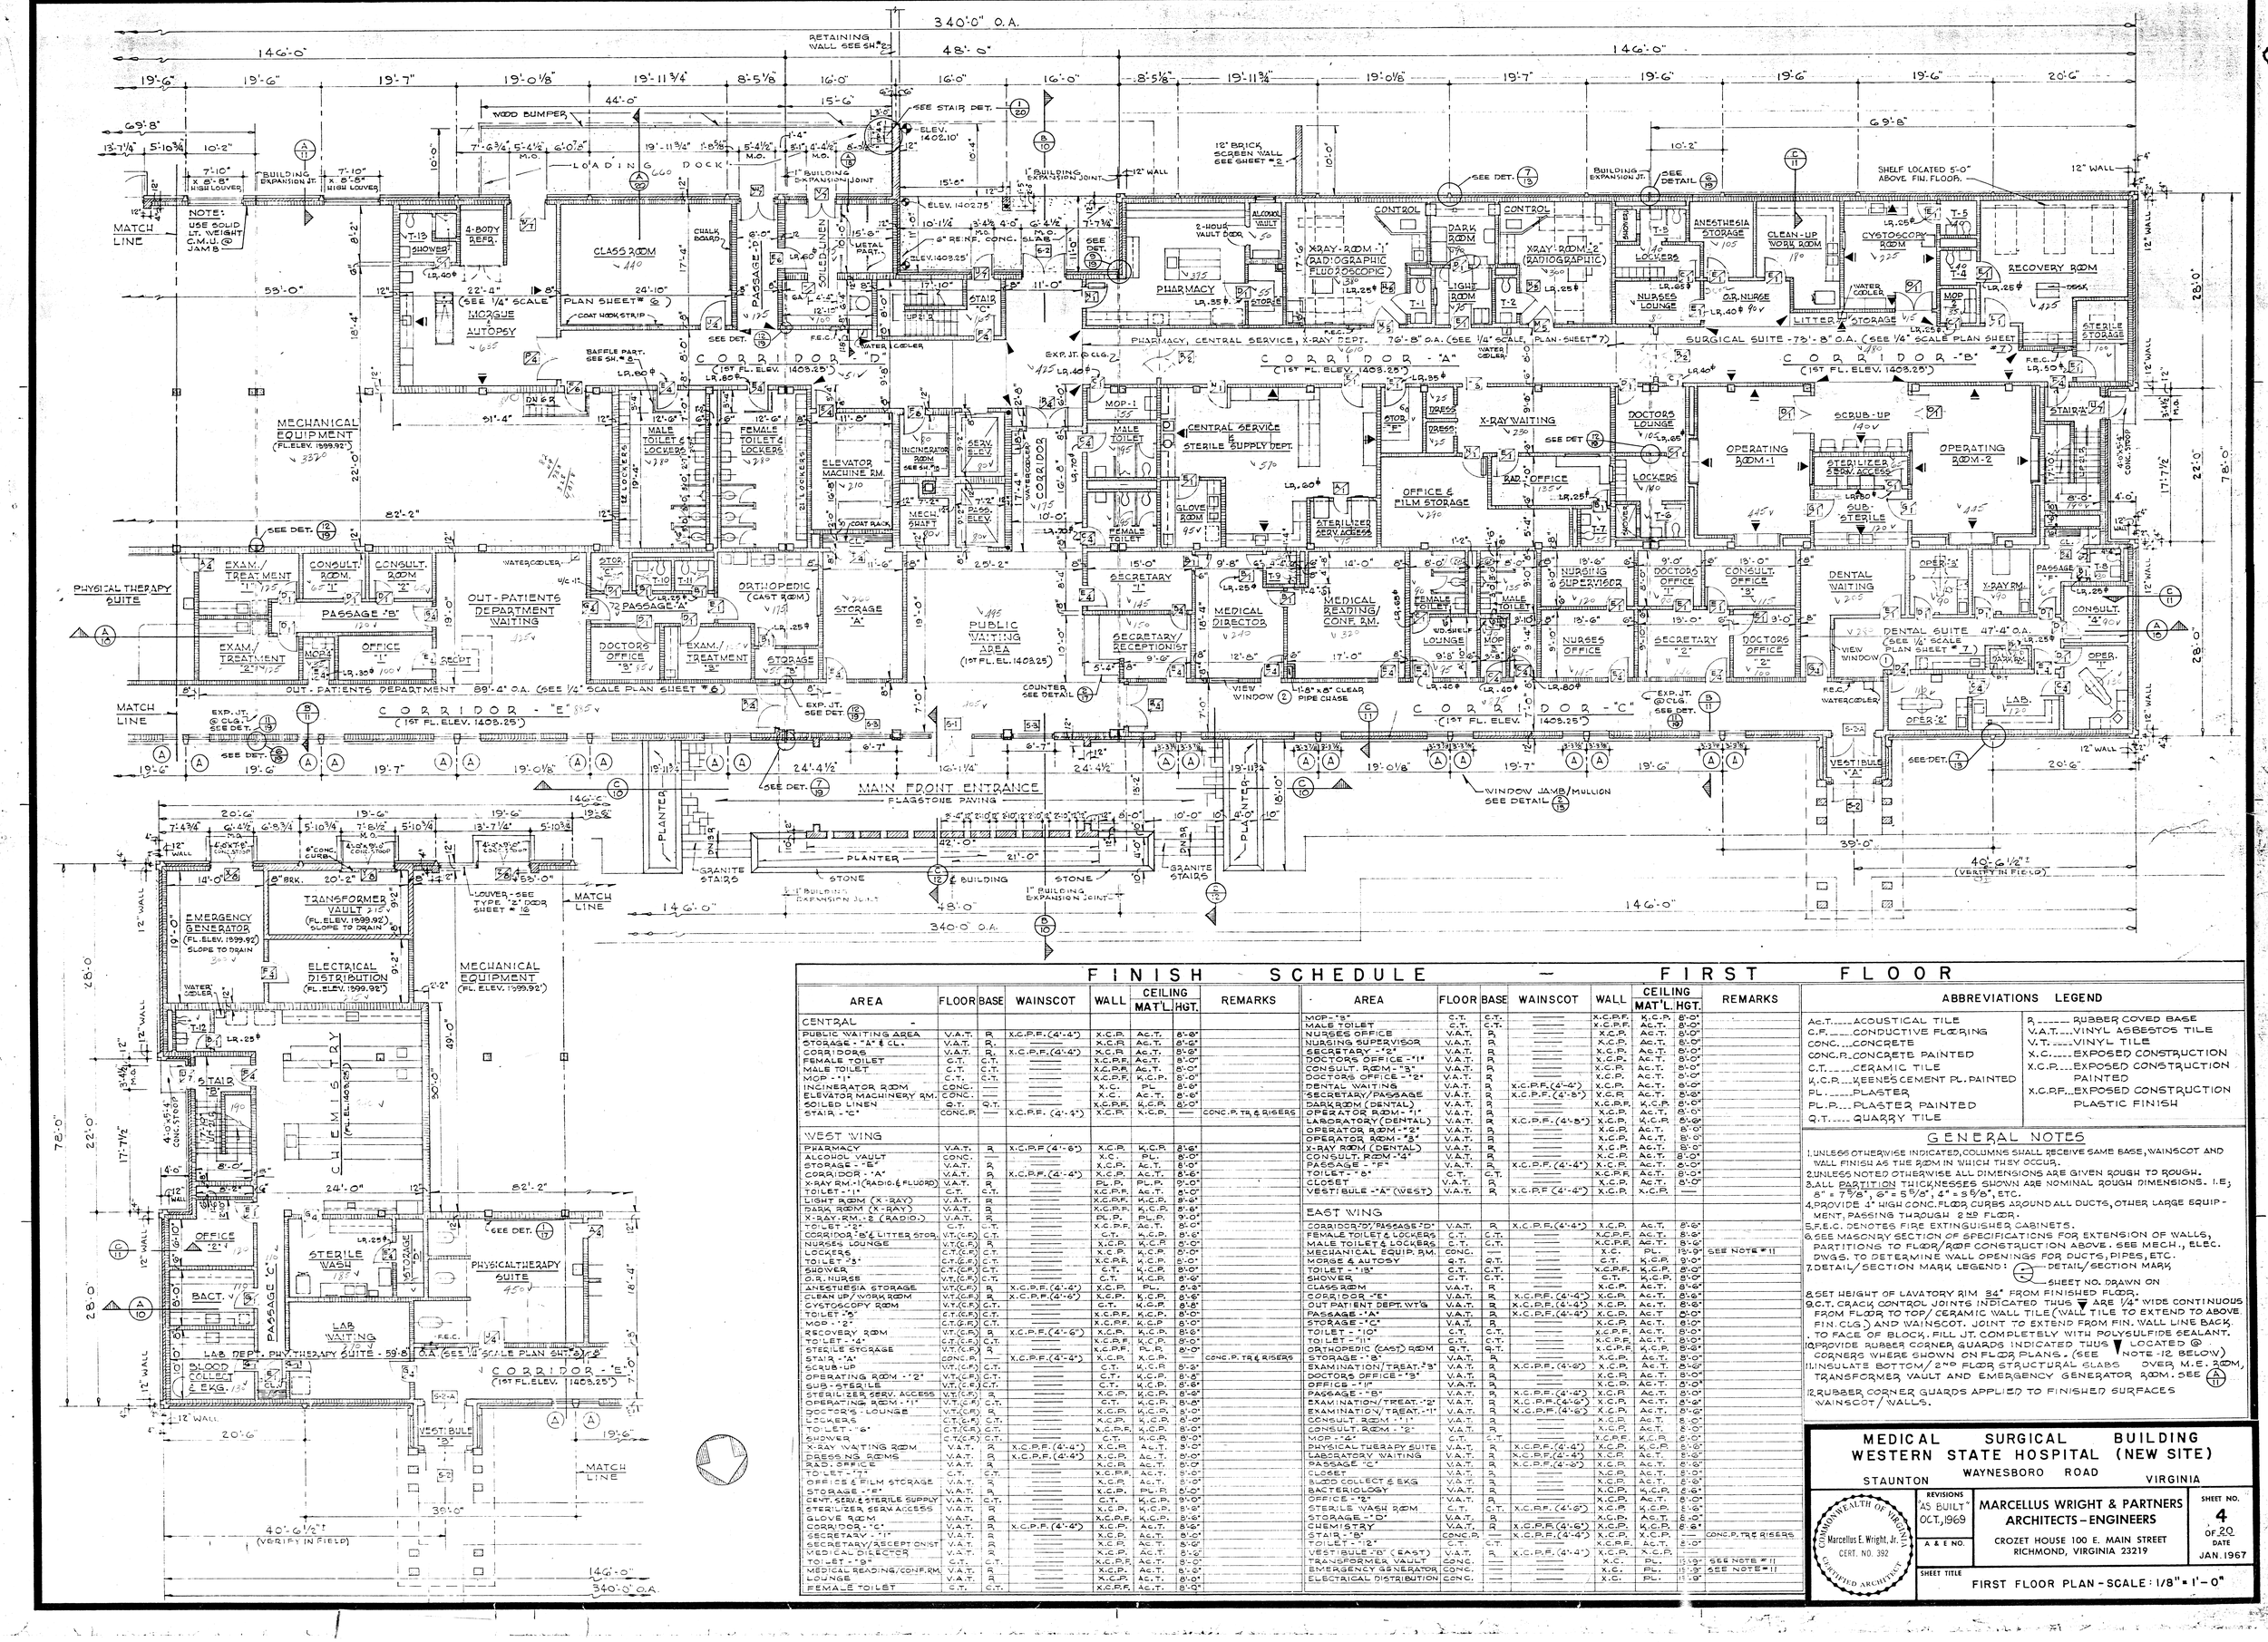

FINISH SCHEDULE — FIRST FLOOR

AREA	FLOOR	BASE	WAINSCOT	WALL	CEILING MAT'L.	CEILING HGT.	REMARKS
CENTRAL							
PUBLIC WAITING AREA	V.A.T.	R.	X.C.P.F. (4'-4")	X.C.P.	Ac.T.	8'-6"	
STORAGE - "A" & CL.	V.A.T.	R.	———	X.C.P.	Ac.T.	8'-6"	
CORR. DORS.	V.A.T.	R.	X.C.P.F. (4'-4")	X.C.P.	Ac.T.	8'-6"	
FEMALE TOILET	C.T.	C.T.	———	X.C.P.F.	Ac.T.	8'-0"	
MALE TOILET	C.T.	C.T.	———	X.C.P.F.	Ac.T.	8'-0"	
MOP - "1"	C.T.	C.T.	———	X.C.P.F.	K.C.P.	8'-0"	
INCINERATOR ROOM	CONC.	—	———	X.C.	PL.	8'-6"	
ELEVATOR MACHINERY RM.	CONC.	—	———	X.C.	Ac.T.	8'-6"	
SOILED LINEN	Q.T.	Q.T.	———	X.C.P.F.	K.C.P.	8'-0"	
STAIR - "C"	CONC.P.	—	X.C.P.F. (4'-4")	X.C.P.	X.C.P.	———	CONC.P. TR. & RISERS
WEST WING							
PHARMACY	V.A.T.	R	X.C.P.F. (4'-6")	X.C.P.	K.C.P.	8'-6"	
ALCOHOL VAULT	CONC.	—	———	X.C.	PL.	8'-0"	
STORAGE - "F"	V.A.T.	R	———	X.C.P.	Ac.T.	8'-0"	
CORRIDOR - "A"	V.A.T.	R	X.C.P.F. (4'-4")	X.C.P.	Ac.T.	8'-6"	
X-RAY RM.-1 (RADIO. & FLUORO)	V.A.T.	R	———	PL.P.	PL.P.	9'-0"	
TOILET - "1"	C.T.	C.T.	———	X.C.P.F.	Ac.T.	8'-0"	
LIGHT ROOM (X-RAY)	V.A.T.	R	———	X.C.P.F.	K.C.P.	8'-6"	
DARK ROOM (X-RAY)	V.A.T.	R	———	X.C.P.F.	K.C.P.	8'-6"	
X-RAY RM.-2 (RADIO.)	V.A.T.	R	———	PL.P.	PL.P.	9'-0"	
TOILET - "2"	C.T.	C.T.	———	X.C.P.F.	Ac.T.	8'-0"	
CORRIDOR - "B" & LITTER STOR.	V.T.(C.F.)	C.T.	———	C.T.	K.C.P.	8'-6"	
NURSES LOUNGE	V.T.(C.F.)	R	———	X.C.P.	K.C.P.	8'-0"	
LOCKERS	C.T.(C.F.)	C.T.	———	X.C.P.	K.C.P.	8'-0"	
TOILET - "3"	C.T.(C.F.)	C.T.	———	X.C.P.F.	K.C.P.	8'-0"	
SHOWER	C.T.(C.F.)	C.T.	———	C.T.	K.C.P.	8'-0"	
O.R. NURSE	V.T.(C.F.)	C.T.	———	C.T.	K.C.P.	8'-6"	
ANESTHESIA STORAGE	V.T.(C.F.)	R	X.C.P.F. (4'-6")	X.C.P.	PL.	8'-6"	
CLEAN UP/WORK ROOM	V.T.(C.F.)	R	X.C.P.F. (4'-6")	X.C.P.	K.C.P.	8'-6"	
CYSTOSCOPY ROOM	V.T.(C.F.)	C.T.	———	C.T.	K.C.P.	8'-6"	
TOILET - "5"	C.T.(C.F.)	C.T.	———	X.C.P.F.	K.C.P.	8'-0"	
MOP - "2"	C.T.(C.F.)	C.T.	———	X.C.P.F.	K.C.P.	8'-0"	
RECOVERY ROOM	V.T.(C.F.)	R	X.C.P.F. (4'-6")	X.C.P.	K.C.P.	8'-6"	
TOILET - "4"	C.T.(C.F.)	C.T.	———	X.C.P.F.	K.C.P.	8'-0"	
STERILE STORAGE	V.T.(C.F.)	R	———	X.C.P.F.	PL.P.	8'-0"	
STAIR - "A"	CONC.P.	R	X.C.P.F. (4'-4")	X.C.P.	X.C.P.	———	CONC.P. TR. & RISERS
SCRUB-UP	V.T.(C.F.)	C.T.	———	C.T.	K.C.P.	8'-6"	
OPERATING ROOM - "2"	V.T.(C.F.)	C.T.	———	C.T.	K.C.P.	8'-6"	
SUB-STERILE	V.T.(C.F.)	C.T.	———	C.T.	K.C.P.	8'-6"	
STERILIZER & SERV. ACCESS	V.T.(C.F.)	C.T.	———	C.T.	K.C.P.	8'-6"	
OPERATING ROOM - "1"	V.T.(C.F.)	C.T.	———	C.T.	K.C.P.	8'-6"	
DOCTORS LOUNGE	V.T.(C.F.)	R	———	X.C.P.	K.C.P.	8'-6"	
LOCKERS	V.T.(C.F.)	C.T.	———	X.C.P.	K.C.P.	8'-0"	
TOILET - "6"	C.T.(C.F.)	C.T.	———	X.C.P.F.	K.C.P.	8'-0"	
SHOWER	C.T.(C.F.)	C.T.	———	C.T.	K.C.P.	8'-0"	
X-RAY WAITING ROOM	V.A.T.	R	X.C.P.F. (4'-4")	X.C.P.	Ac.T.	8'-6"	
DRESSING ROOMS	V.A.T.	R	X.C.P.F. (4'-4")	X.C.P.	Ac.T.	8'-6"	
RAD. OFFICE	V.A.T.	R	———	X.C.P.	Ac.T.	8'-6"	
TOILET - "7"	C.T.	C.T.	———	X.C.P.F.	Ac.T.	8'-0"	
OFFICE & FILM STORAGE	V.A.T.	R	———	X.C.P.	Ac.T.	8'-0"	
STORAGE - "E"	V.A.T.	R	———	X.C.P.	PL.P.	8'-6"	
CENT. SERV. & STERILE SUPPLY	V.A.T.	C.T.	———	C.T.	K.C.P.	9'-0"	
STERILIZER SERV. ACCESS	V.A.T.	C.T.	———	X.C.P.	K.C.P.	9'-0"	
GLOVE ROOM	V.A.T.	R	———	X.C.P.F.	K.C.P.	8'-6"	
CORRIDOR - "C"	V.A.T.	R	X.C.P.F. (4'-6")	X.C.P.	Ac.T.	8'-6"	
SECRETARY - "1"	V.A.T.	R	———	X.C.P.	Ac.T.	8'-0"	
SECRETARY/RECEPTIONIST	V.A.T.	R	———	X.C.P.	Ac.T.	8'-0"	
MEDICAL DIRECTOR	V.A.T.	R	———	X.C.P.	Ac.T.	8'-6"	
TOILET - "9"	C.T.	C.T.	———	X.C.P.F.	Ac.T.	8'-0"	
MEDICAL READING/CONF. RM.	V.A.T.	R	———	X.C.P.	Ac.T.	8'-6"	
LOUNGE	V.A.T.	R	———	X.C.P.	Ac.T.	8'-6"	
FEMALE TOILET	C.T.	C.T.	———	X.C.P.F.	Ac.T.	8'-0"	
MOP - "3"	C.T.	C.T.	———	X.C.P.F.	K.C.P.	8'-0"	
MALE TOILET	C.T.	C.T.	———	X.C.P.F.	Ac.T.	8'-0"	
NURSES OFFICE	V.A.T.	R	———	X.C.P.	Ac.T.	8'-0"	
NURSING SUPERVISOR	V.A.T.	R	———	X.C.P.	Ac.T.	8'-0"	
SECRETARY - "2"	V.A.T.	R	———	X.C.P.	Ac.T.	8'-0"	
DOCTORS OFFICE - "1"	V.A.T.	R	———	X.C.P.	Ac.T.	8'-0"	
CONSULT. ROOM - "3"	V.A.T.	R	———	X.C.P.	Ac.T.	8'-0"	
DOCTORS OFFICE - "2"	V.A.T.	R	———	X.C.P.	Ac.T.	8'-0"	
DENTAL WAITING	V.A.T.	R	X.C.P.F. (4'-4")	X.C.P.	Ac.T.	8'-0"	
SECRETARY/PASSAGE	V.A.T.	R	X.C.P.F. (4'-8")	X.C.P.	Ac.T.	8'-6"	
DARK ROOM (DENTAL)	V.A.T.	R	———	X.C.P.F.	K.C.P.	8'-0"	
OPERATOR ROOM - "1"	V.A.T.	R	———	X.C.P.	Ac.T.	8'-0"	
LABORATORY (DENTAL)	V.A.T.	R	X.C.P.F. (4'-8")	X.C.P.	K.C.P.	8'-6"	
OPERATOR ROOM - "2"	V.A.T.	R	———	X.C.P.	Ac.T.	8'-0"	
OPERATOR ROOM - "3"	V.A.T.	R	———	X.C.P.	Ac.T.	8'-0"	
X-RAY ROOM (DENTAL)	V.A.T.	R	———	X.C.P.	Ac.T.	8'-0"	
CONSULT. ROOM - "4"	V.A.T.	R	———	X.C.P.	Ac.T.	8'-0"	
PASSAGE - "F"	V.A.T.	R	X.C.P.F. (4'-4")	X.C.P.	Ac.T.	8'-0"	
TOILET - "8"	C.T.	C.T.	———	X.C.P.F.	Ac.T.	8'-0"	
CLOSET	V.A.T.	R	———	X.C.P.	Ac.T.	8'-0"	
VESTIBULE - "A" (WEST)	V.A.T.	R	X.C.P.F. (4'-4")	X.C.P.	X.C.P.	———	
EAST WING							
CORRIDOR - "D", PASSAGE - "D"	V.A.T.	R	X.C.P.F. (4'-4")	X.C.P.	Ac.T.	8'-6"	
FEMALE TOILET & LOCKERS	C.T.	C.T.	———	X.C.P.F.	Ac.T.	8'-0"	
MALE TOILET & LOCKERS	C.T.	C.T.	———	X.C.P.F.	Ac.T.	8'-0"	
MECHANICAL EQUIP. RM.	CONC.	—	———	X.C.	PL.	13'-9"	SEE NOTE # 11
MORGE & AUTOSY	Q.T.	Q.T.	———	C.T.	K.C.P.	9'-0"	
TOILET - "18"	C.T.	C.T.	———	X.C.P.F.	K.C.P.	8'-0"	
SHOWER	C.T.	C.T.	———	C.T.	K.C.P.	8'-0"	
CLASS ROOM	V.A.T.	R	———	X.C.P.	Ac.T.	8'-6"	
CORRIDOR - "E"	V.A.T.	R	X.C.P.F. (4'-4")	X.C.P.	Ac.T.	8'-6"	
OUT-PATIENT DEPT. WTG	V.A.T.	R	X.C.P.F. (4'-4")	X.C.P.	Ac.T.	8'-6"	
PASSAGE - "A"	V.A.T.	R	X.C.P.F. (4'-4")	X.C.P.	Ac.T.	8'-0"	
STORAGE - "C"	V.A.T.	R	———	X.C.P.	Ac.T.	8'-0"	
TOILET - "10"	C.T.	C.T.	———	X.C.P.F.	Ac.T.	8'-0"	
TOILET - "11"	C.T.	C.T.	———	X.C.P.F.	Ac.T.	8'-0"	
ORTHOPEDIC (CAST) ROOM	Q.T.	Q.T.	———	X.C.P.F.	K.C.P.	8'-0"	
STORAGE - "B"	V.A.T.	R	———	X.C.P.	Ac.T.	8'-0"	
EXAMINATION/TREAT. "3"	V.A.T.	R	X.C.P.F. (4'-8")	X.C.P.	Ac.T.	8'-6"	
DOCTORS OFFICE - "3"	V.A.T.	R	———	X.C.P.	Ac.T.	8'-0"	
OFFICE - "1"	V.A.T.	R	———	X.C.P.	Ac.T.	8'-0"	
PASSAGE - "B"	V.A.T.	R	X.C.P.F. (4'-4")	X.C.P.	Ac.T.	8'-0"	
EXAMINATION/TREAT. "2"	V.A.T.	R	X.C.P.F. (4'-6")	X.C.P.	Ac.T.	8'-6"	
EXAMINATION/TREAT. "1"	V.A.T.	R	X.C.P.F. (4'-6")	X.C.P.	Ac.T.	8'-6"	
CONSULT. ROOM - "1"	V.A.T.	R	———	X.C.P.	Ac.T.	8'-0"	
CONSULT. ROOM - "2"	V.A.T.	R	———	X.C.P.	Ac.T.	8'-0"	
MOP - "4"	C.T.	C.T.	———	X.C.P.F.	K.C.P.	8'-0"	
PHYSICAL THERAPY SUITE	V.A.T.	R	X.C.P.F. (4'-4")	X.C.P.	K.C.P.	8'-6"	
LABORATORY WAITING	V.A.T.	R	X.C.P.F. (4'-4")	X.C.P.	Ac.T.	8'-6"	
PASSAGE "C"	V.A.T.	R	X.C.P.F. (4'-6")	X.C.P.	Ac.T.	8'-6"	
CLOSET	V.A.T.	R	———	X.C.P.	Ac.T.	8'-0"	
BLOOD COLLECT & EKG	V.A.T.	R	———	X.C.P.	Ac.T.	8'-0"	
BACTERIOLOGY	V.A.T.	R	———	X.C.P.	K.C.P.	8'-6"	
OFFICE - "2"	V.A.T.	R	———	X.C.P.	Ac.T.	8'-0"	
STERILIZE WASH ROOM	C.T.	C.T.	X.C.P.F. (4'-6")	X.C.P.	K.C.P.	8'-6"	
STORAGE - "D"	V.A.T.	R	———	X.C.P.	Ac.T.	8'-0"	
CHEMISTRY	V.A.T.	R	X.C.P.F. (4'-6")	X.C.P.	K.C.P.	8'-6"	
STAIR - "B"	CONC.P.	—	X.C.P.F. (4'-4")	X.C.P.	X.C.P.	———	CONC.P. TR. & RISERS
TOILET - "12"	C.T.	C.T.	———	X.C.P.F.	Ac.T.	8'-0"	
VESTIBULE - "B" (EAST)	V.A.T.	R	X.C.P.F. (4'-4")	X.C.P.	X.C.P.	———	
TRANSFORMER VAULT	CONC.	—	———	X.C.	PL.	15'-0"	SEE NOTE # 11
EMERGENCY GENERATOR	CONC.	—	———	X.C.	PL.	15'-0"	SEE NOTE # 11
ELECTRICAL DISTRIBUTION	CONC.	—	———	X.C.	PL.	15'-9"	

ABBREVIATIONS LEGEND

Ac.T. ..... ACOUSTICAL TILE	R. ..... RUBBER COVED BASE
C.F. ..... CONDUCTIVE FLOORING	V.A.T. ..... VINYL ASBESTOS TILE
CONC. ..... CONCRETE	V.T. ..... VINYL TILE
CONC.P. ..... CONCRETE PAINTED	X.C. ..... EXPOSED CONSTRUCTION
C.T. ..... CERAMIC TILE	X.C.P. ..... EXPOSED CONSTRUCTION PAINTED
K.C.P. ..... KEENES CEMENT PL. PAINTED	X.C.P.F. ..... EXPOSED CONSTRUCTION PLASTIC FINISH
PL. ..... PLASTER	
PL.P. ..... PLASTER PAINTED	
Q.T. ..... QUARRY TILE	

GENERAL NOTES

1. UNLESS OTHERWISE INDICATED, COLUMNS SHALL RECEIVE SAME BASE, WAINSCOT AND WALL FINISH AS THE ROOM IN WHICH THEY OCCUR.
2. UNLESS NOTED OTHERWISE ALL DIMENSIONS ARE GIVEN ROUGH TO ROUGH.
3. ALL PARTITION THICKNESSES SHOWN ARE NOMINAL ROUGH DIMENSIONS. I.E; 8" = 7 7/8", 6" = 5 5/8", 4" = 3 5/8", ETC.
4. PROVIDE 4" HIGH CONC. FLOOR CURBS AROUND ALL DUCTS, OTHER LARGE EQUIPMENT, PASSING THROUGH 2ND FLOOR.
5. F.E.C. DENOTES FIRE EXTINGUISHER CABINETS.
6. SEE MASONRY SECTION OF SPECIFICATIONS FOR EXTENSION OF WALLS, PARTITIONS TO FLOOR/ROOF CONSTRUCTION ABOVE. SEE MECH., ELEC. DWGS. TO DETERMINE WALL OPENINGS FOR DUCTS, PIPES, ETC.
7. DETAIL/SECTION MARK LEGEND: (A/11) DETAIL/SECTION MARK; 11 SHEET NO. DRAWN ON
8. SET HEIGHT OF LAVATORY RIM 34" FROM FINISHED FLOOR.
9. C.T. CRACK CONTROL JOINTS INDICATED THUS ▼ ARE 1/4" WIDE CONTINUOUS FROM FLOOR TO TOP/CERAMIC WALL TILE (WALL TILE TO EXTEND TO ABOVE FIN. CLG.) AND WAINSCOT. JOINT TO EXTEND FROM FIN. WALL LINE BACK TO FACE OF BLOCK. FILL JT. COMPLETELY WITH POLYSULFIDE SEALANT.
10. PROVIDE RUBBER CORNER GUARDS INDICATED THUS ▼ LOCATED @ CORNERS WERE SHOWN ON FLOOR PLANS. (SEE ▼ NOTE-12 BELOW)
11. INSULATE BOTTOM/2ND FLOOR STRUCTURAL SLABS OVER M.E. ROOM, TRANSFORMER VAULT AND EMERGENCY GENERATOR ROOM. SEE (A/11)
12. RUBBER CORNER GUARDS APPLIED TO FINISHED SURFACES WAINSCOT/WALLS.

MEDICAL SURGICAL BUILDING
WESTERN STATE HOSPITAL (NEW SITE)
STAUNTON WAYNESBORO ROAD VIRGINIA

Marcellus E. Wright, Jr. CERT. NO. 392 — COMMONWEALTH OF VIRGINIA — CERTIFIED ARCHITECT

REVISIONS: "AS BUILT" OCT., 1969; A & E NO.

MARCELLUS WRIGHT & PARTNERS
ARCHITECTS - ENGINEERS
CROZET HOUSE 100 E. MAIN STREET
RICHMOND, VIRGINIA 23219

SHEET NO. 4 OF 20
DATE JAN. 1967

SHEET TITLE: FIRST FLOOR PLAN - SCALE: 1/8" = 1'-0"

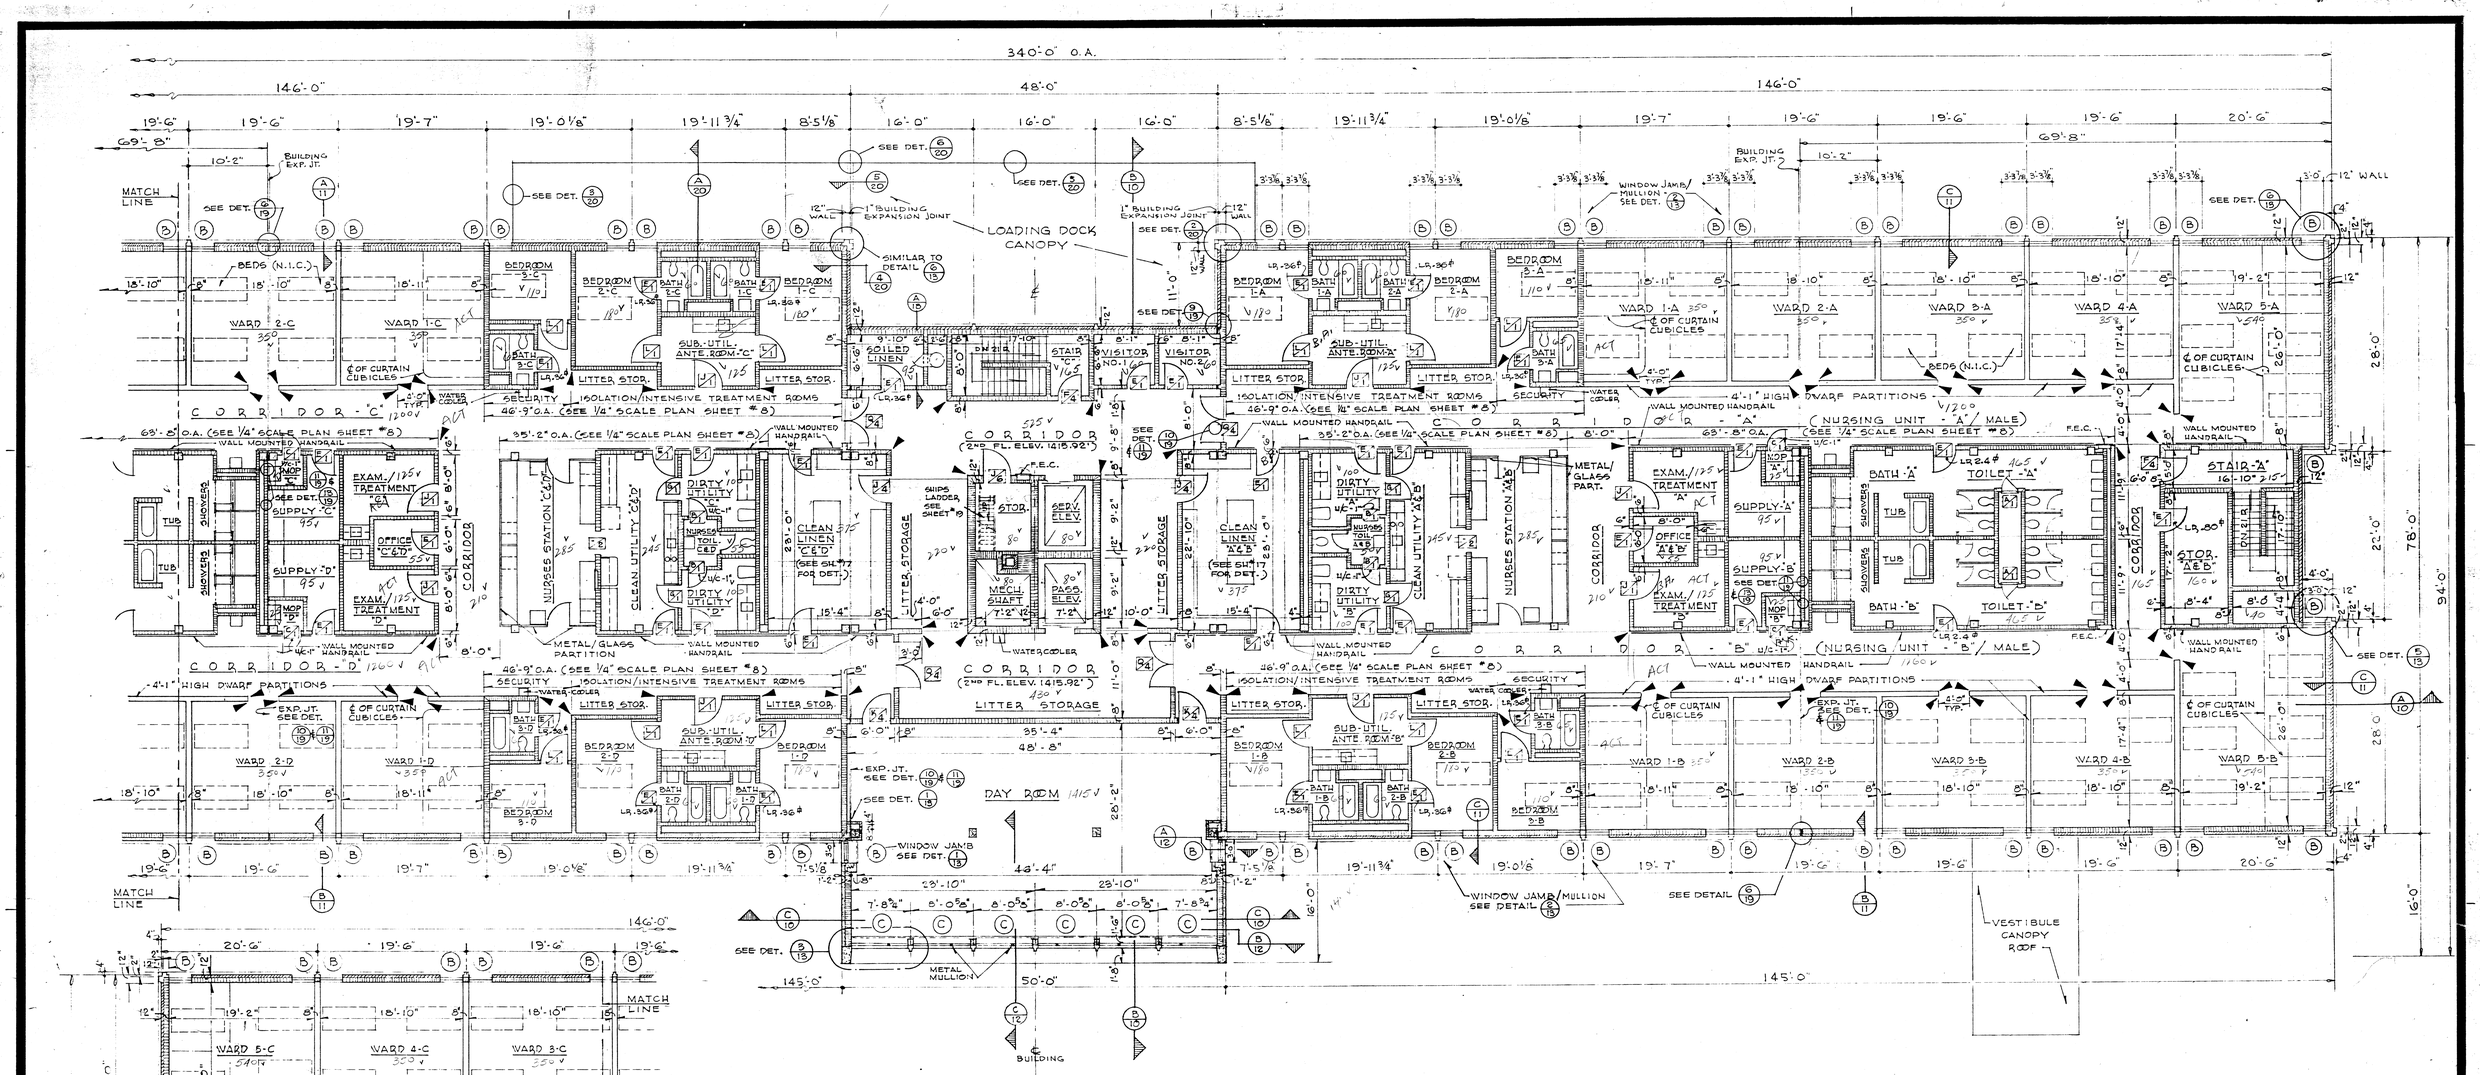

FINISH SCHEDULE — SECOND FLOOR

AREA	FLOOR	BASE	WAINSCOT	WALL	CEILING MAT'L.	CEILING HGT.	REMARKS
CENTRAL							
CORRIDORS/LITTER STOR.	V.A.T.	R	X.C.P.F. (4'-4")	X.C.P.	Ac.T.	8'-6"	
DAY ROOM	V.A.T.	R	X.C.P.F. (4'-4")	X.C.P.	Ac.T.	8'-6"	
SOILED LINEN R.OOM	V.A.T.	R		X.C.P.F.	K.C.P.	8'-6"	
STAIR "C"	CONC.P.	R	X.C.P.F. (4'-4")	X.C.P.	Ac.T.	8'-6"	CONC.P. TR & RISERS
VISITOR - "1"	V.A.T.	R		X.C.P.	Ac.T.	8'-0"	
VISITOR - "2"	V.A.T.	R		X.C.P.	Ac.T.	8'-0"	
STORAGE	CONC.	—		X.C.	X.C.	—	
WEST WING							
CORRIDORS/LITTER STOR.	V.A.T.	R	X.C.P.F. (4'-4")	X.C.P.	Ac.T.	8'-6"	
BED R.OM 1-A	V.A.T.	R		X.C.P.	K.C.P.	8'-6"	
BATH 1-A	C.T.	C.T.	C.T. TUB AREA ONLY	X.C.P.F.	K.C.P.	8'-0"	
SUB-UTIL. ANTE RM. - "A"	V.A.T.	R		X.C.P.F.	K.C.P.	8'-6"	
BED ROOM 2-A	V.A.T.	R		X.C.P.	K.C.P.	8'-6"	
BATH 2-A	C.T.	C.T.	C.T. TUB AREA ONLY	X.C.P.F.	K.C.P.	8'-0"	
BED R.OM 3-A	V.A.T.	R		X.C.P.	K.C.P.	8'-6"	
BATH 3-A	C.T.	C.T.	C.T. TUB AREA ONLY	X.C.P.F.	K.C.P.	8'-0"	
WARD 1-A	V.A.T.	R	X.C.P.F. (4'-4")	X.C.P.	Ac.T.	8'-6"	
WARD 2-A	V.A.T.	R	X.C.P.F. (4'-4")	X.C.P.	Ac.T.	8'-6"	
WARD 3-A	V.A.T.	R	X.C.P.F. (4'-4")	X.C.P.	Ac.T.	8'-6"	
WARD 4-A	V.A.T.	R	X.C.P.F. (4'-4")	X.C.P.	Ac.T.	8'-6"	
WARD 5-A	V.A.T.	R	X.C.P.F. (4'-4")	X.C.P.	Ac.T.	8'-6"	
STAIR "A" & "B"	CONC.P.	—	X.C.P.F. (4'-4")	X.C.P.	Ac.T.	8'-6"	CONC.P. TR & RISERS
STORAGE "A" & "B"	V.A.T.	R		X.C.P.	X.C.P.	—	
TOILET - "A"	C.T.	C.T.		X.C.P.F.	K.C.P.	8'-6"	
BATH - "A" (INCLUDES SH. & TUB)	C.T.	C.T.		C.T.	K.C.P.	8'-0"	
MOP - "A"	C.T.	C.T.		X.C.P.F.	K.C.P.	8'-0"	
SUPPLY - "A"	V.A.T.	R		X.C.P.	Ac.T.	8'-0"	
EXAMINATION/TREAT. - "A"	V.A.T.	R	X.C.P.F. (4'-6")	X.C.P.	Ac.T.	8'-6"	
OFFICE "A" & "B"	V.A.T.	R		X.C.P.	Ac.T.	8'-6"	
NURSES STATION "A" & "B"	V.A.T.	R	X.C.P.F. (4'-4")	X.C.P.	Ac.T.	8'-6"	
CLEAN UTILITY - "A" & "B"	C.T.	C.T.		X.C.P.F.	K.C.P.	8'-6"	
DIRTY UTILITY - "A"	C.T.	C.T.		X.C.P.F.	K.C.P.	8'-6"	
NURSES TOILET - "A" & "B"	C.T.	C.T.		X.C.P.F.	K.C.P.	8'-0"	
CLEAN LINEN STOR. "A" & "B"	V.A.T.	R		X.C.P.	K.C.P.	8'-6"	
CORRIDORS/LITTER STOR.	V.A.T.	R	X.C.P.F. (4'-4")	X.C.P.	Ac.T.	8'-6"	
DIRTY UTILITY - "B"	C.T.	C.T.		X.C.P.F.	K.C.P.	8'-6"	
EXAMINATION/TREAT. - "B"	V.A.T.	R	X.C.P.F. (4'-6")	X.C.P.	Ac.T.	8'-6"	
SUPPLY - "B"	V.A.T.	R		X.C.P.	Ac.T.	8'-0"	
MOP - "B"	C.T.	C.T.		X.C.P.F.	K.C.P.	8'-0"	
BATH - "B" (INCLUDES SH. & TUB)	C.T.	C.T.		C.T.	K.C.P.	8'-0"	
TOILET - "B"	C.T.	C.T.		X.C.P.F.	K.C.P.	8'-6"	
BED ROOM 1-B	V.A.T.	R		X.C.P.	K.C.P.	8'-6"	
BATH - B	C.T.	C.T.	C.T. TUB AREA ONLY	X.C.P.F.	K.C.P.	8'-0"	
SUB-UTIL. ANTE ROOM - "B"	V.A.T.	R		X.C.P.F.	K.C.P.	8'-6"	
BED ROOM 2-B	V.A.T.	R		X.C.P.	K.C.P.	8'-6"	
BATH 2-B	C.T.	C.T.	C.T. TUB AREA ONLY	X.C.P.F.	K.C.P.	8'-0"	
BEDROOM 3-B	V.A.T.	R		X.C.P.	K.C.P.	8'-6"	
BATH 3-B	C.T.	C.T.	C.T. TUB AREA ONLY	X.C.P.F.	K.C.P.	8'-0"	
WARD 1-B	V.A.T.	R	X.C.P.F. (4'-4")	X.C.P.	Ac.T.	8'-6"	
WARD 2-B	V.A.T.	R	X.C.P.F. (4'-4")	X.C.P.	Ac.T.	8'-6"	
WARD 3-B	V.A.T.	R	X.C.P.F. (4'-4")	X.C.P.	Ac.T.	8'-6"	
WARD 4-B	V.A.T.	R	X.C.P.F. (4'-4")	X.C.P.	Ac.T.	8'-6"	
WARD 5-B	V.A.T.	R	X.C.P.F. (4'-4")	X.C.P.	Ac.T.	8'-6"	
EAST WING							
CORRIDORS/LITTER STOR.	V.A.T.	R	X.C.P.F. (4'-4")	X.C.P.	Ac.T.	8'-6"	
BED R.OM 1-C	V.A.T.	R		X.C.P.	K.C.P.	8'-6"	
BATH 1-C	C.T.	C.T.	C.T. TUB AREA ONLY	X.C.P.F.	K.C.P.	8'-0"	
SUBUTIL. ANTE RM. "C"	V.A.T.	R		X.C.P.F.	K.C.P.	8'-6"	
BED R.OM 2-C	V.A.T.	R		X.C.P.	K.C.P.	8'-6"	
BATH 2-C	C.T.	C.T.	C.T. TUB AREA ONLY	X.C.P.F.	K.C.P.	8'-0"	
BED R.OM 3-C	V.A.T.	R		X.C.P.	K.C.P.	8'-6"	
BATH 3-C	C.T.	C.T.	C.T. TUB AREA ONLY	X.C.P.F.	K.C.P.	8'-0"	
WARD 1-C	V.A.T.	R	X.C.P.F. (4'-4")	X.C.P.	Ac.T.	8'-6"	
WARD 2-C	V.A.T.	R	X.C.P.F. (4'-4")	X.C.P.	Ac.T.	8'-6"	
WARD 3-C	V.A.T.	R	X.C.P.F. (4'-4")	X.C.P.	Ac.T.	8'-6"	
WARD 4-C	V.A.T.	R	X.C.P.F. (4'-4")	X.C.P.	Ac.T.	8'-6"	
WARD 5-C	V.A.T.	R	X.C.P.F. (4'-4")	X.C.P.	Ac.T.	8'-6"	
STAIR - "B"	CONC.P.	—	X.C.P.F. (4'-4")	X.C.P.	Ac.T.	8'-6"	CONC.P. TR & RISERS
STORAGE "C" & "D"	V.A.T.	R		X.C.P.	X.C.P.	—	
TOILET - "C"	C.T.	C.T.		X.C.P.F.	K.C.P.	8'-6"	
BATH - "C" (INCLUDES SH. & TUB)	C.T.	C.T.		C.T.	K.C.P.	8'-0"	
MOP - "C"	C.T.	C.T.		X.C.P.F.	K.C.P.	8'-0"	
SUPPLY - "C"	V.A.T.	R		X.C.P.	Ac.T.	8'-0"	
EXAMINATION/TREAT. "C"	V.A.T.	R	X.C.P.F. (4'-6")	X.C.P.	Ac.T.	8'-6"	
OFFICE "C" & "D"	V.A.T.	R		X.C.P.	Ac.T.	8'-6"	
NURSES STATION "C" & "D"	V.A.T.	R	X.C.P.F. (4'-4")	X.C.P.	Ac.T.	8'-6"	
CLEAN UTILITY - "C" & "D"	C.T.	C.T.		X.C.P.F.	K.C.P.	8'-6"	
DIRTY UTILITY - "C"	C.T.	C.T.		X.C.P.F.	K.C.P.	8'-6"	
NURSES TOILET - "C" & "D"	C.T.	C.T.		X.C.P.F.	K.C.P.	8'-0"	
CLEAN LINEN STOR. "C" & "D"	V.A.T.	R		X.C.P.	K.C.P.	8'-6"	
CORRIDORS/LITTER STOR.	V.A.T.	R	X.C.P.F. (4'-4")	X.C.P.	Ac.T.	8'-6"	
DIRTY UTILITY - "D"	C.T.	C.T.		X.C.P.F.	K.C.P.	8'-6"	
EXAMINAT ON/TREAT. - "D"	V.A.T.	R	X.C.P.F. (4'-6")	X.C.P.	Ac.T.	8'-6"	
SUPPLY - "D"	V.A.T.	R		X.C.P.	Ac.T.	8'-0"	
MOP - "D"	C.T.	C.T.		X.C.P.F.	K.C.P.	8'-0"	
BATH - "D" (INCLUDES SH. & TUB)	C.T.	C.T.		C.T.	K.C.P.	8'-0"	
TOILET - "D"	C.T.	C.T.		X.C.P.F.	K.C.P.	8'-6"	
BED R.OM 1-D	V.A.T.	R		X.C.P.	K.C.P.	8'-6"	
BATH 1-D	C.T.	C.T.	C.T. TUB AREA ONLY	X.C.P.F.	K.C.P.	8'-0"	
SUB-UTIL. ANTE R.M. "D"	V.A.T.	R		X.C.P.F.	K.C.P.	8'-6"	
BED ROOM 2-D	V.A.T.	R		X.C.P.	K.C.P.	8'-6"	
BATH 2-D	C.T.	C.T.	C.T. TUB AREA ONLY	X.C.P.F.	K.C.P.	8'-0"	
BED ROOM 3-D	V.A.T.	R		X.C.P.	K.C.P.	8'-6"	
BATH 3-D	C.T.	C.T.	C.T. TUB AREA ONLY	X.C.P.F.	K.C.P.	8'-0"	
WARD 1-D	V.A.T.	R	X.C.P.F. (4'-4")	X.C.P.	Ac.T.	8'-6"	
WARD 2-D	V.A.T.	R	X.C.P.F. (4'-4")	X.C.P.	Ac.T.	8'-6"	
WARD 3-D	V.A.T.	R	X.C.P.F. (4'-4")	X.C.P.	Ac.T.	8'-6"	
WARD 4-D	V.A.T.	R	X.C.P.F. (4'-4")	X.C.P.	Ac.T.	8'-6"	
WARD 5-D	V.A.T.	R	X.C.P.F. (4'-4")	X.C.P.	Ac.T.	8'-6"	

ABBREVIATIONS LEGEND

Ac.T. ... ACOUSTICAL TILE
C.F. ... CONDUCTIVE FLOORING
CONC. ... CONCRETE
CONC.P. CONCRETE PAINTED
C.T. ... CERAMIC TILE
K.C.P. ... KSENES CEMENT PL. PAINTED
PL. ... PLASTER
PL. P. ... PLASTER PAINTED
Q.T. ... QUARRY TILE
R. ... RUBBER COVED BASE
V.A.T. ... VINYL ASBESTOS TILE
V.T. ... VINYL TILE
X.C. ... EXPOSED CONSTRUCTION
X.C.P. ... EXPOSED CONSTRUCTION PAINTED
X.C.P.F. ... EXPOSED CONSTRUCTION PLASTIC FINISH

GENERAL NOTES

1. SEE GENERAL NOTES ON SHEET "4"
2. CERAMIC TILE WAINSCOT HEIGHT = 6'-10"
3. DWARF PARTITIONS TO BE LIGHT WEIGHT CONCRETE MASONRY UNITS, X.C.P.F. WITH CERAMIC TILE CAP.

APPROX. BLDG. AREA

FIRST FL. ..... 27,697 S.F.
SECOND FL. ..... 26,569 S.F.
SCREENED OFF M.E. SPACE ON ROOF (FIGURED @ 1/4 VALUE - THIS REPRESENTS 2,586 S.F. OF ACTUAL AREA) ..... 647 S.F.
TOTAL ..... 54,913 S.F.

APPROX. BLDG. VOLUME

FIRST FL. ..... 354,844 C.F.
SECOND FL. ..... 327,596 C.F.
SCREENED OFF M.E. SPACE ON ROOF ..... 5,690 C.F.
TOTAL ..... 688,130 C.F.

CAPACITY
100 ..... BEDS

MEDICAL SURGICAL BUILDING
WESTERN STATE HOSPITAL (NEW SITE)

WAYNESBORO ROAD
STAUNTON — VIRGINIA

Marcellus E. Wright, Jr. CERT. NO. 392 — COMMONWEALTH OF VIRGINIA — CERTIFIED ARCHITECT

REVISIONS: "AS BUILT" OCT., 1969

A & E NO.

MARCELLUS WRIGHT & PARTNERS
ARCHITECTS — ENGINEERS
CROZET HOUSE 100 E. MAIN STREET
RICHMOND, VIRGINIA 23219

SHEET NO. 5 OF 20
DATE JAN 1967

SHEET TITLE: SECOND FLOOR PLAN - SCALE: 1/8" = 1'-0"

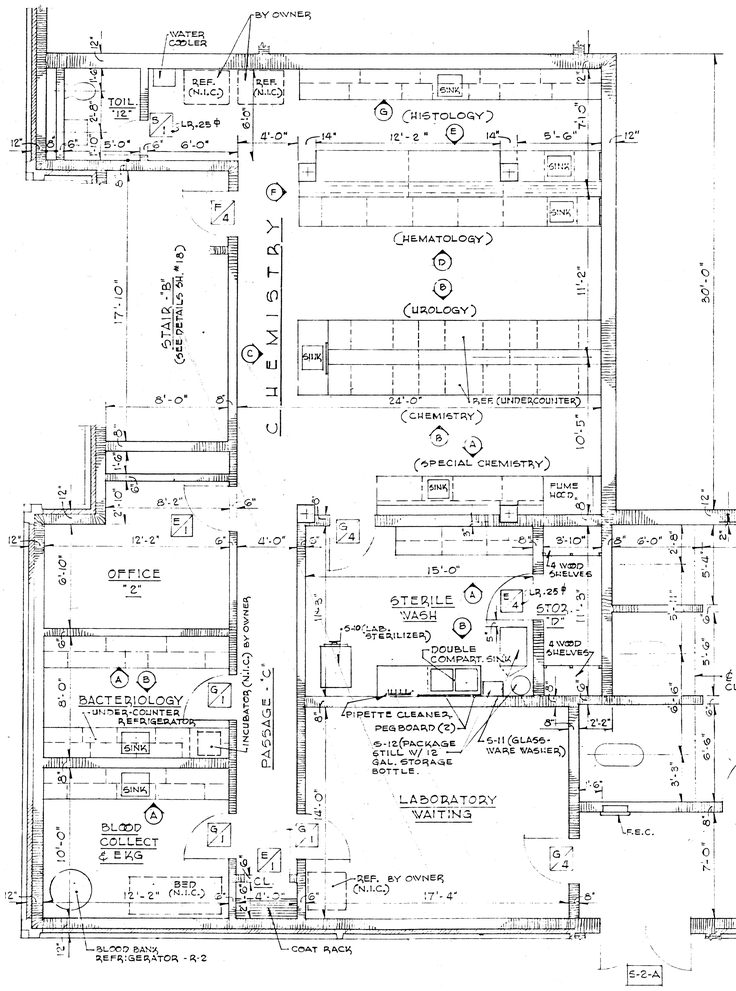

PLAN - LABORATORY, PHYSICAL-THERAPY SUITE & OUT-PATIENTS DEPARTMENT

SEE 1/8" SCALE DRAWING SHEET # 4

SCALE: 1/4" = 1'-0"

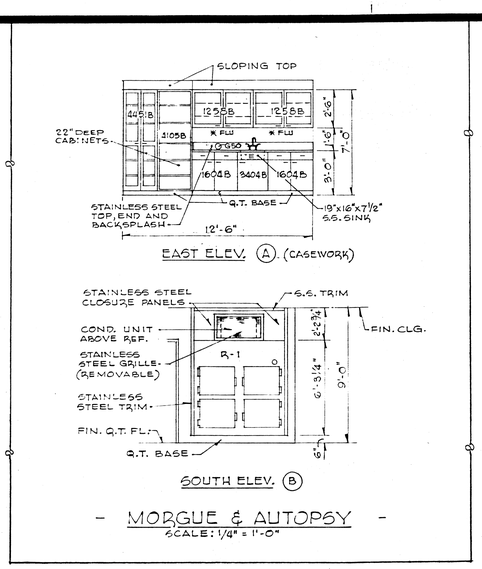

- MORGUE & AUTOPSY -

SCALE: 1/4" = 1'-0"

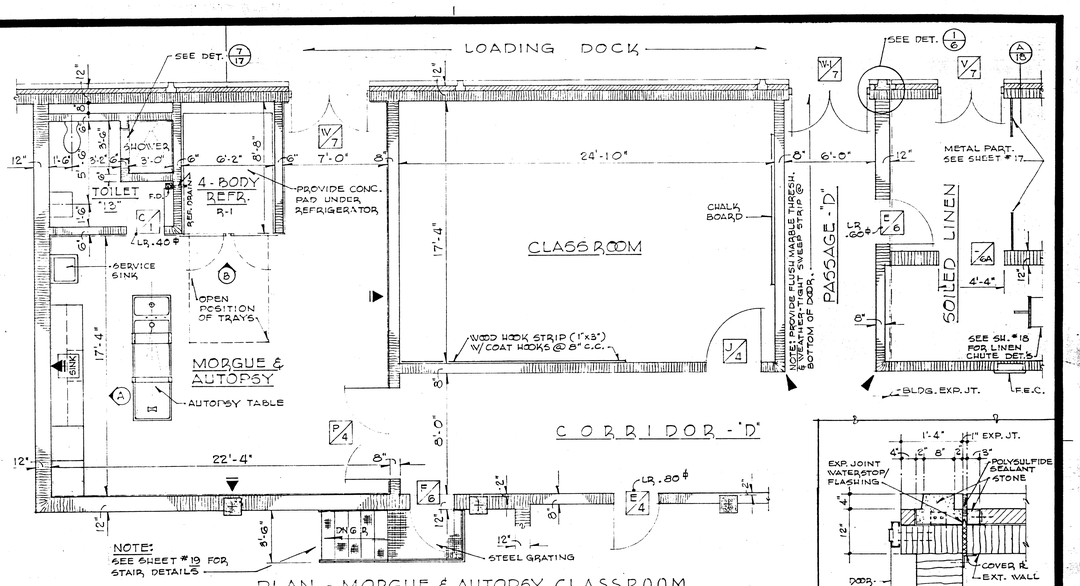

PLAN - MORGUE & AUTOPSY, CLASSROOM

SEE 1/8" SCALE DRAWING SHEET # 4

SCALE: 1/4" = 1'-0"

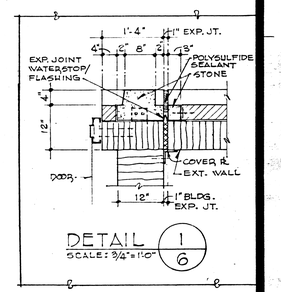

DETAIL (1/6)

SCALE: 3/4" = 1'-0"

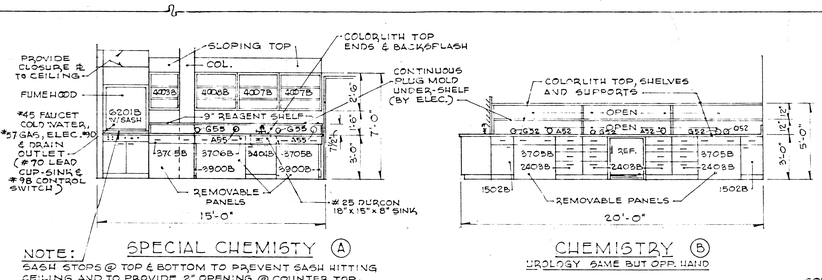

NOTE:
SASH STOPS @ TOP & BOTTOM TO PREVENT SASH HITTING CEILING AND TO PROVIDE 2" OPENING @ COUNTER TOP.

SPECIAL CHEMISTY (A)

CHEMISTRY (B)

UROLOGY SAME BUT OPP. HAND

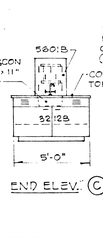

END ELEV. (C)

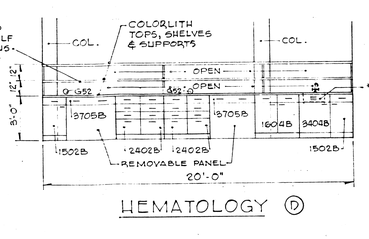

HEMATOLOGY (D)

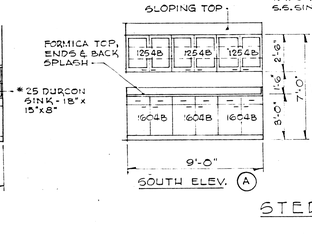

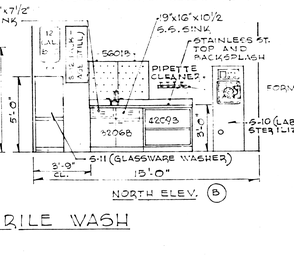

STERILE WASH

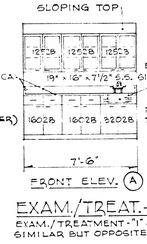

EXAM./TREAT."2"

EXAM./TREATMENT -"1" & "3" SIMILAR BUT OPPOSITE HAND

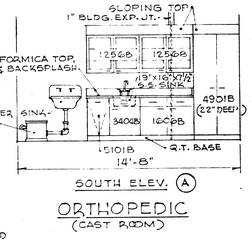

ORTHOPEDIC (CAST ROOM)

- OUT-PATIENT DEPARTMENT -

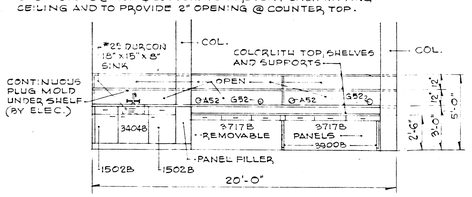

HISTOLOGY (NORTH ELEV.) (E)

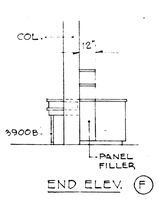

END ELEV. (F)

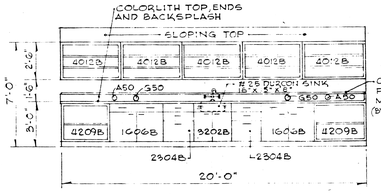

HISTOLOGY (SOUTH ELEV.) (G)

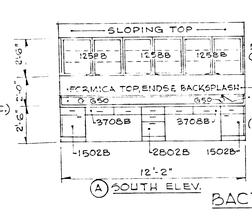

(A) SOUTH ELEV. BACTERIOLOGY

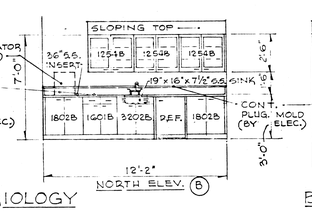

NORTH ELEV. (B)

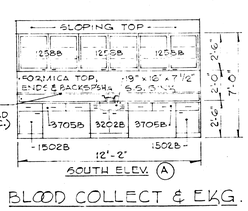

SOUTH ELEV. (A)

BLOOD COLLECT & EKG.

- CASEWORK ELEVATIONS -

SCALE: 1/4" = 1'-0"

NOTES:
1. SEE SHEET # 8 FOR ADDITIONAL NOTES.
2. SEAL IN ALL END/BACKSPLASHES TO WALLS W/ POLYSULFIDE SEALANT.
3. ALL UNDERCOUNTER REFRIGERATORS TO BE MODEL M2IIIO MARVEL 8.7 CU. FT. FINISHED TO MATCH CASEWORK.

- LABORATORY DEPARTMENT -

MEDICAL SURGICAL BUILDING
WESTERN STATE HOSPITAL (NEW SITE)
STAUNTON WAYNESBORO ROAD VIRGINIA

Marcellus E. Wright, Jr. CERT. NO. 392 — COMMONWEALTH OF VIRGINIA — CERTIFIED ARCHITECT

REVISIONS: "AS BUILTS" OCT. 1969

A & E NO.

MARCELLUS WRIGHT & PARTNERS
ARCHITECTS – ENGINEERS
CROZET HOUSE 100 E. MAIN STREET
RICHMOND, VIRGINIA 23219

SHEET NO. 6 OF 20

DATE JAN 1967

SHEET TITLE: PARTIAL EAST WING FIRST FLOOR PLAN
SCALE: 1/4"=1'-0"

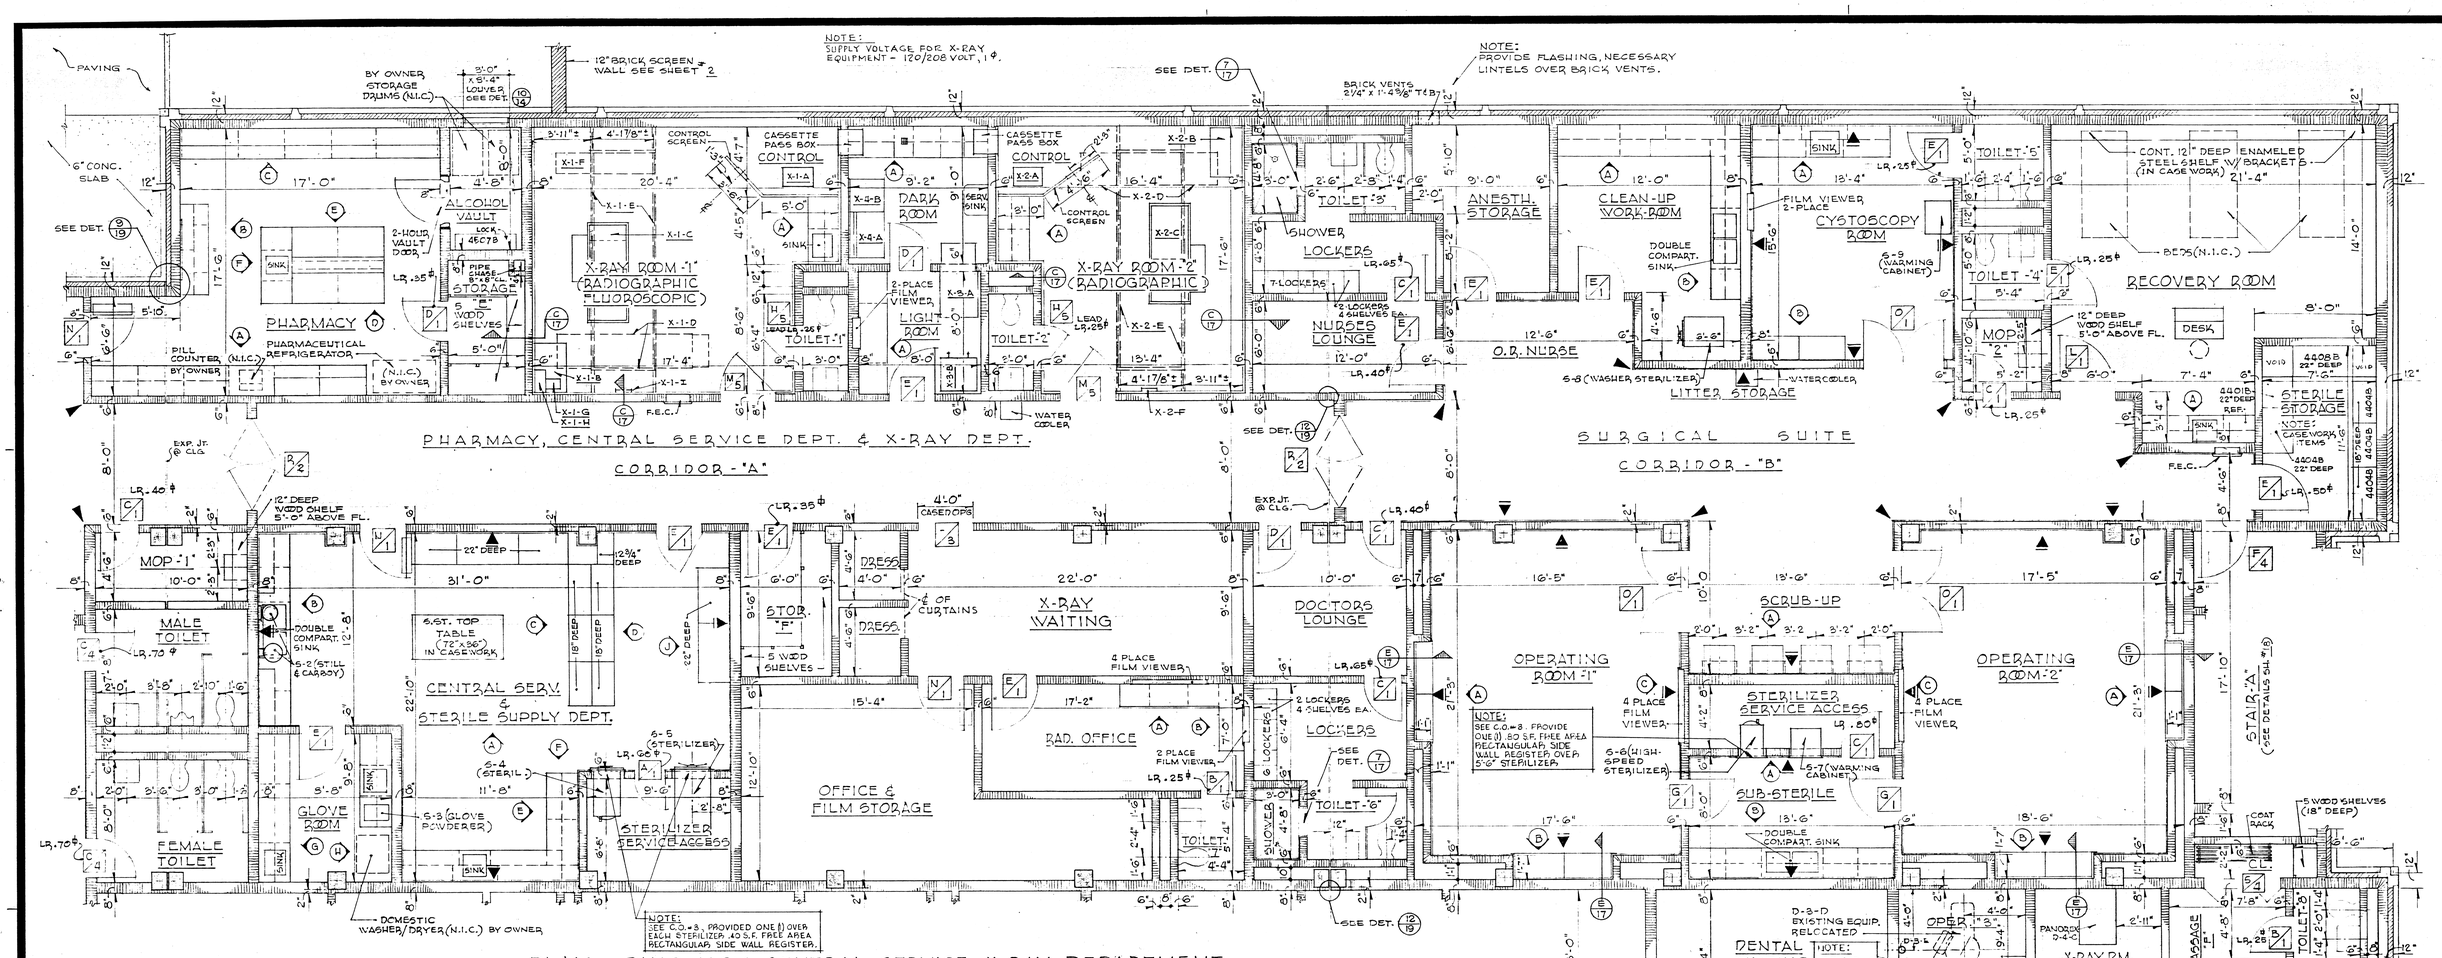

PLAN - PHARMACY, CENTRAL SERVICE, X-RAY DEPARTMENT, SURGICAL & DENTAL SUITE

SEE 1/8" SCALE DRAWINGS SHEET # 4

SCALE: 1/4" = 1'-0"

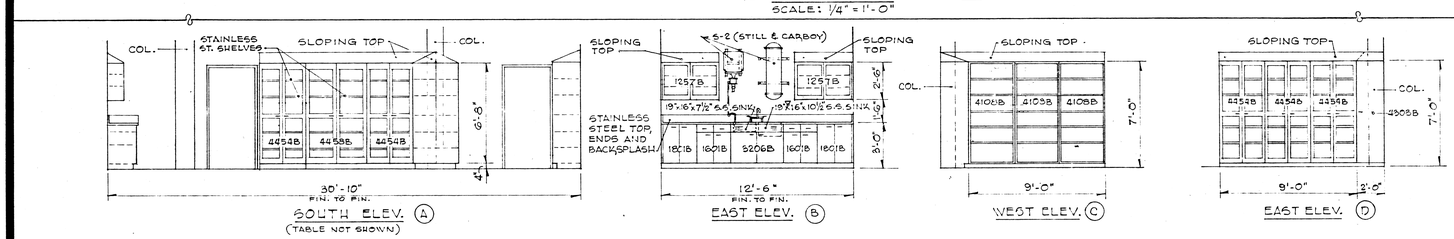

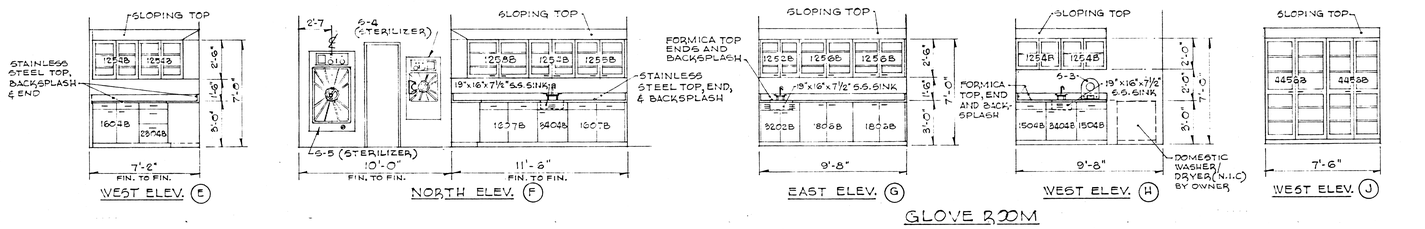

GLOVE ROOM - CENTRAL SERVICE DEPARTMENT -

SCALE: 1/4" = 1'-0"

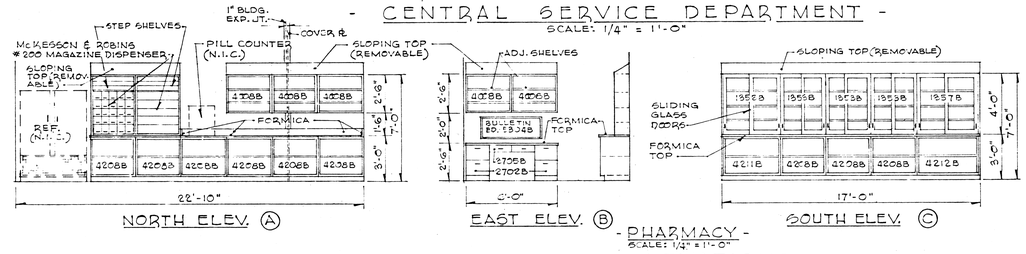

- PHARMACY -

SCALE: 1/4" = 1'-0"

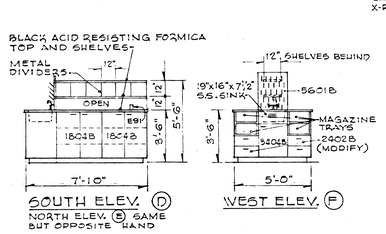

CASEWORK ELEVATIONS (SURGICAL/DENTAL ELEVATIONS SEE SH. #8)

SCALE: 1/4" = 1'-0" (SEE SHEETS #6 & #8 FOR CASEWORK NOTES)

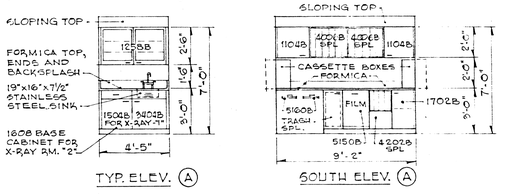

LIGHT ROOM

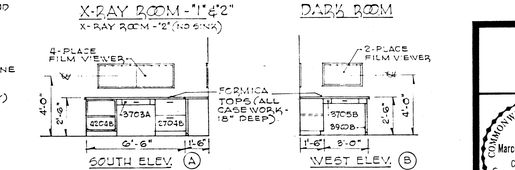

- X-RAY DEPARTMENT -

BAD. - OFFICE

MEDICAL SURGICAL BUILDING WESTERN STATE HOSPITAL (NEW SITE) STAUNTON WAYNESBORO ROAD VIRGINIA	
COMMONWEALTH OF VIRGINIA — Marcellus E. Wright, Jr. CERT. NO. 392 — CERTIFIED ARCHITECT	REVISIONS "AS BUILT" OCT. 1969 A & E NO.
MARCELLUS WRIGHT & PARTNERS ARCHITECTS - ENGINEERS CROZET HOUSE 100 E. MAIN STREET RICHMOND, VIRGINIA 23219	SHEET NO. 7 OF 20 DATE JAN 1967
SHEET TITLE: PARTIAL WEST WING FIRST FLOOR PLAN SCALE - 1/4"=1'-0"	